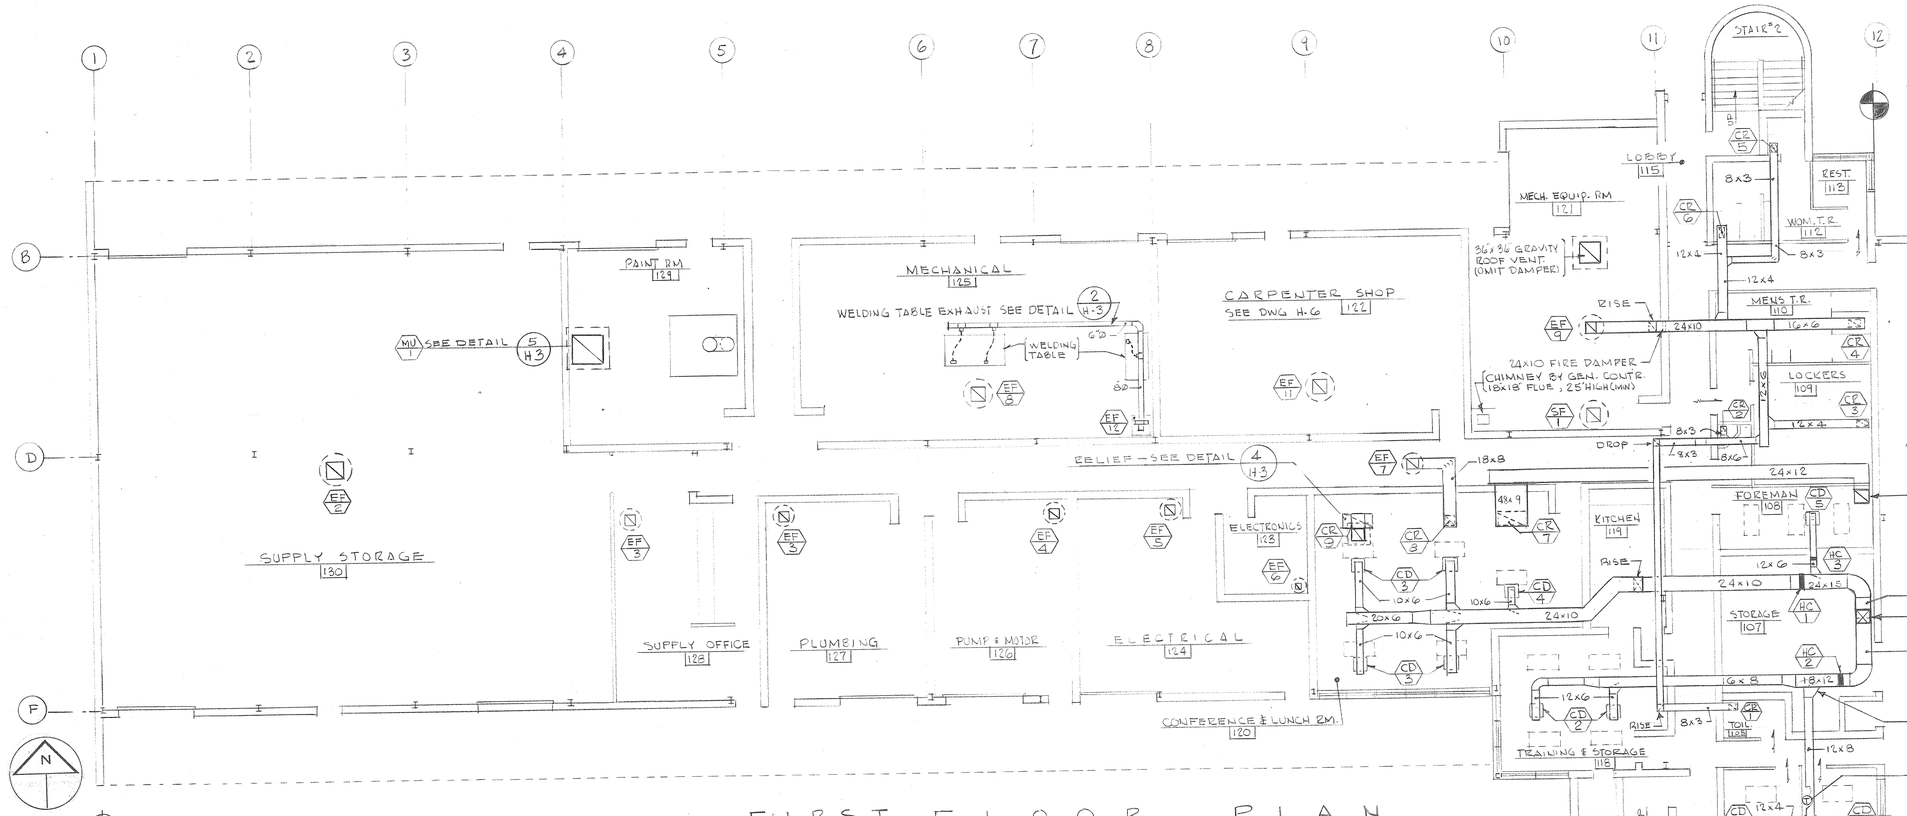

NOTE

ALL DUCT SIZES SHOWN ON DRAWINGS ARE NET INSIDE DIMENSIONS. WHERE DUCT LINER IS USED, THE LINER THICK. (2x1") OF 2" MUST BE ADDED TO THE NET DUCT SIZE TO OBTAIN THE SHEET METAL DUCT SIZE. (TYPICAL FOR ALL LINED DUCTS)

FIRST FLOOR PLAN

1/8" = 1'-0"

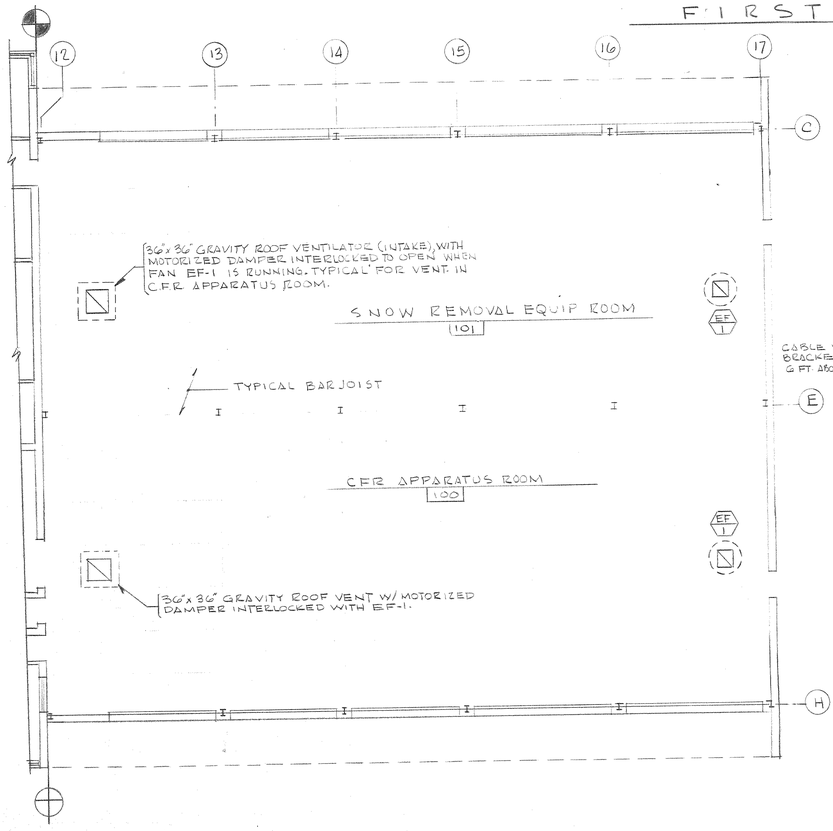

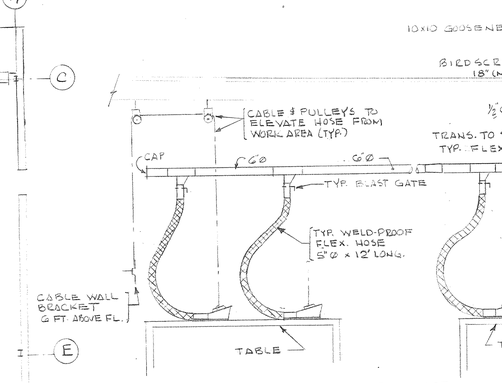

WELDING TABLE EXHAUST DETAIL 2 H3
NTS

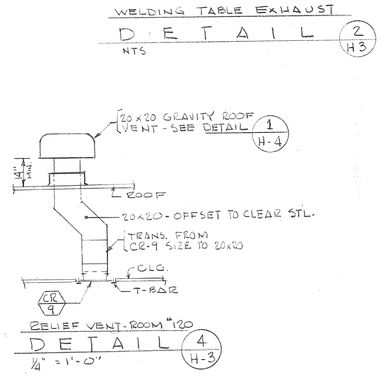

DETAIL 5 H-3
½" = 1'-0"

DETAIL 4 H-3
¼" = 1'-0"

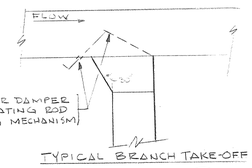

TYPICAL BRANCH TAKE-OFF DETAIL 3 H-3
NTS

DESCRIPTION	DESCRIPTION
AS BUILT REVISIONS	

SUBMITTED ARCHITECT — Gerald F. DeMarco
SUBMITTED ENGINEER — Gerald F. DeMarco
APPROVED DEPARTMENT OF TRANSPORTATION
APPROVED

CHECKED BY DEPARTMENT OF GENERAL SERVICES

ARCH.	STRUCT.	H.V.A.C. 3-21-80 8-16-80	PLBG.	ELECT.	MISC.

REGISTERED ARCHITECT PENNSYLVANIA — GERALD F. DEMARCO — CLARKS-SUMMIT, PA.
COMMONWEALTH OF PENNSYLVANIA REGISTERED PROFESSIONAL ENGINEER — WILLIAM JOSEPH BURKAVAGE — NO. 9140 — PENNSYLVANIA

COMMONWEALTH OF PENNSYLVANIA
DEPARTMENT OF GENERAL SERVICES
HARRISBURG PENNSYLVANIA

PROJECT NO. D.G.S. 960-10

EMERGENCY EQUIPMENT & MAINTENANCE BUILDING
HARRISBURG INTERNATIONAL AIRPORT
MIDDLETOWN DAUPHIN COUNTY PENNSYLVANIA

GERALD F. DE MARCO	BURKAVAGE-EVANS ASSOCIATES
REGISTERED ARCHITECT	CONSULTING ENGINEERS
276 EAST GROVE AVE. CLARKS-SUMMIT, PENNA.	709 NORTH STATE ST. CLARKS-SUMMIT, PENNA.

HVAC - DUCT PLAN AND DETAILS

DRAWN BY	DATE	DRAWING NO.
P.J.G	8-11-80	H-3
CHECKED BY	SCALE	
T.J.C.H	NOTED	